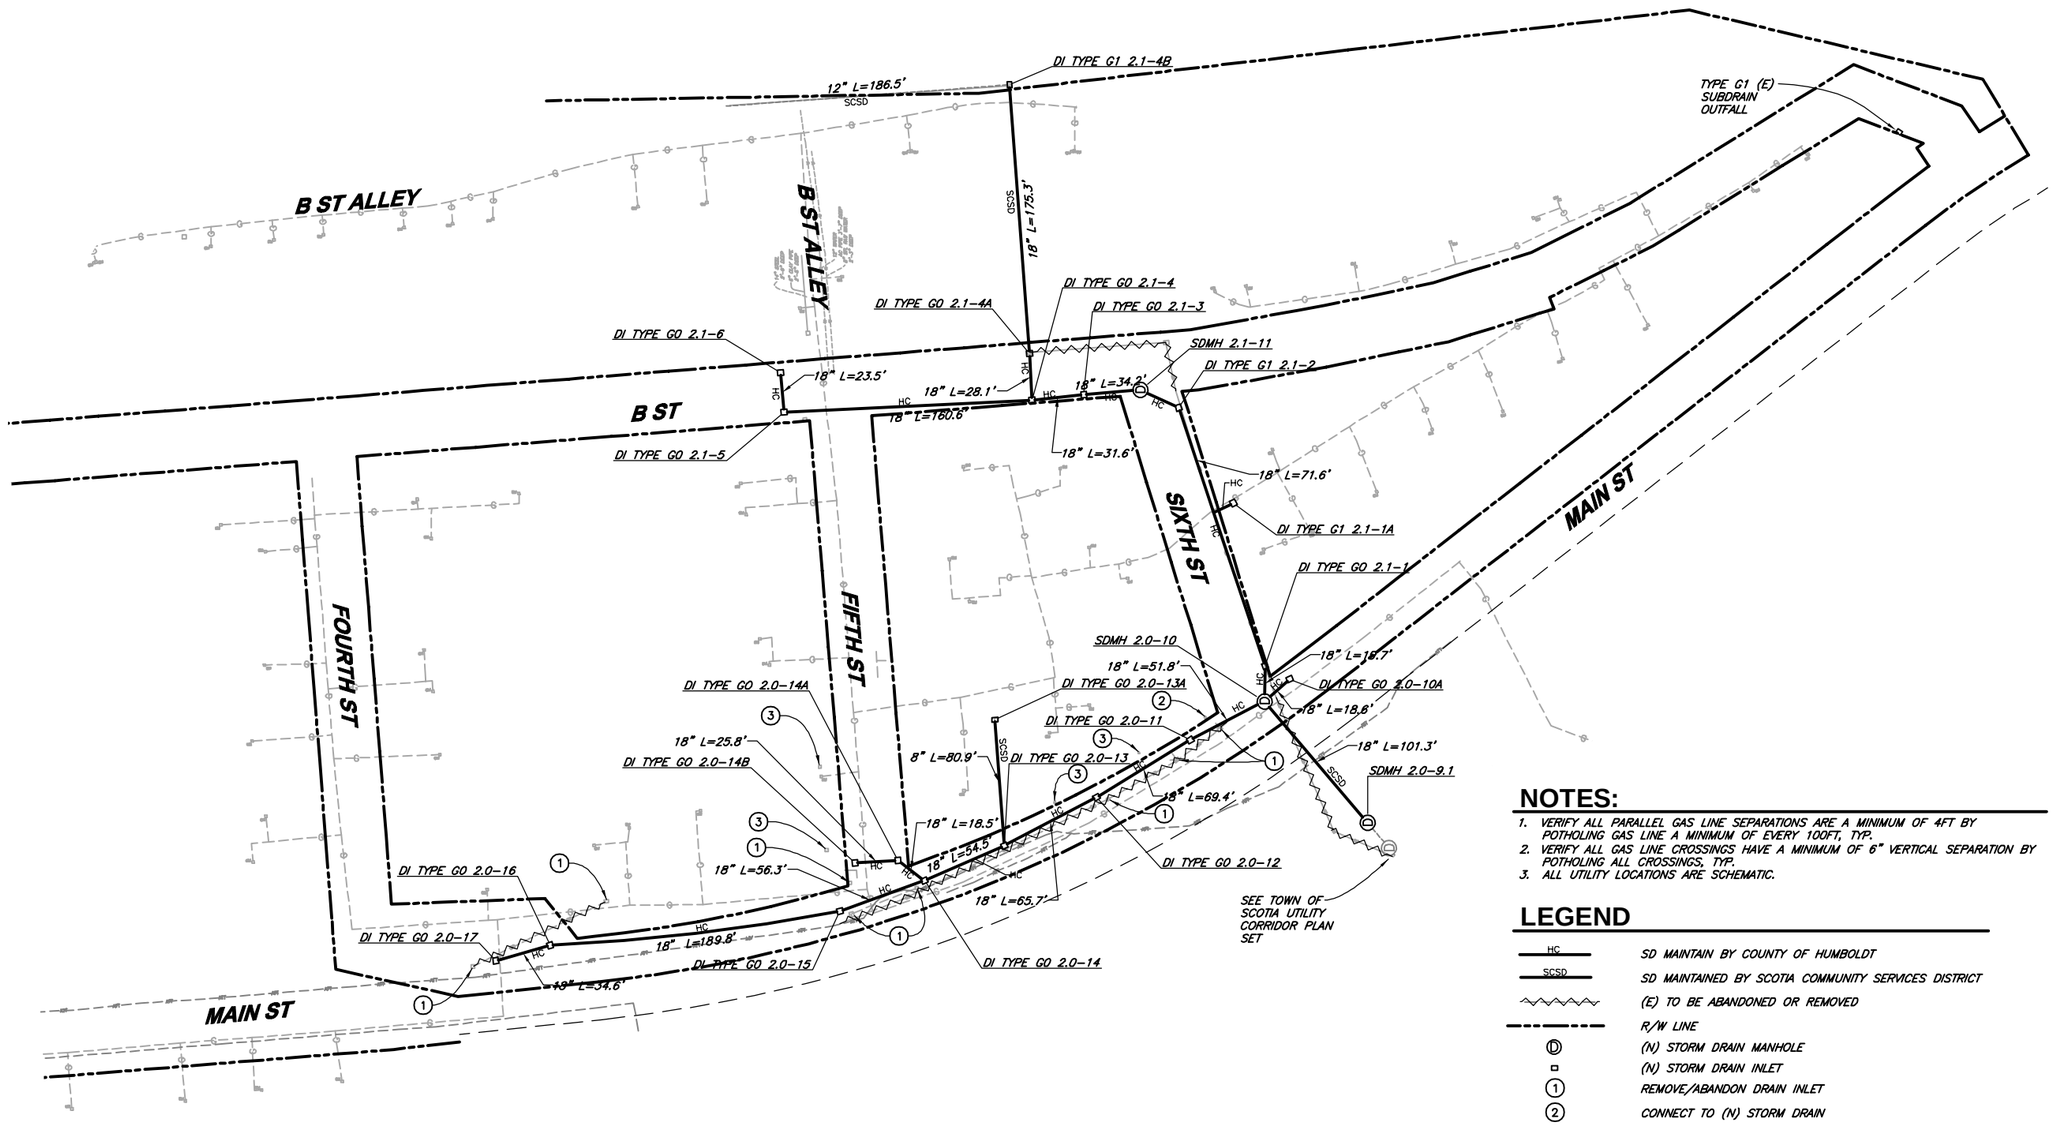

NOTES:

1. VERIFY ALL PARALLEL GAS LINE SEPARATIONS ARE A MINIMUM OF 4FT BY POTHOLING GAS LINE A MINIMUM OF EVERY 100FT, TYP.
2. VERIFY ALL GAS LINE CROSSINGS HAVE A MINIMUM OF 6" VERTICAL SEPARATION BY POTHOLING ALL CROSSINGS, TYP.
3. ALL UTILITY LOCATIONS ARE SCHEMATIC.

LEGEND

HC	SD MAINTAIN BY COUNTY OF HUMBOLDT
SCSD	SD MAINTAINED BY SCOTIA COMMUNITY SERVICES DISTRICT
	(E) TO BE ABANDONED OR REMOVED
	R/W LINE
Ⓓ	(N) STORM DRAIN MANHOLE
▫	(N) STORM DRAIN INLET
1	REMOVE/ABANDON DRAIN INLET
2	CONNECT TO (N) STORM DRAIN
3	(E) STRUCTURE TO REMAIN

NOTE: ALL UTILITY LOCATIONS ARE SCHEMATIC

1"=50'

PHASE 3

RECORD DRAWING

THIS RECORD DRAWING HAS BEEN PREPARED, IN PART, ON THE BASIS OF INFORMATION COMPILED AND FURNISHED BY OTHERS AND NOT VERIFIED BY THE ENGINEER. THIS IS NOT A CERTIFIED DOCUMENT AS TO THE ORIGINAL DOCUMENT BUT AS TO THE REVISIONS TO THIS DRAWING ISSUED AND SEALED BY:
CODY J. LONG
#85605
ON 03/25/2020
THE RECORD DRAWING IS ONLY CERTIFIED AS TO THE REVISIONS. FIELD VERIFICATION OF CRITICAL FACTS AND DATA MUST BE MADE IF THIS DOCUMENT IS TO BE USED AS A BASIS FOR FUTURE WORK.

REGISTERED PROFESSIONAL ENGINEER JASON G. SHY No. 76097 Exp. 12/31/23 CIVIL STATE OF CALIFORNIA
PRELIMINARY

VERIFY SCALES
BAR IS ONE INCH ON ORIGINAL DRAWING
0 1"
IF NOT ONE INCH ON THIS SHEET, ADJUST SCALES ACCORDINGLY

SHY CONSULTING ENGINEERS & GEOLOGISTS, INC.
812 W. WABASH AVE. EUREKA, CA. 95501
WWW.SHY-ENGR.COM 707-441-8855

NO.	DATE	REVISION	BY
1	12/22/2022	RECORD DRAWINGS	CDN

DSGN CJL
DR CJL/CDN
CHK JGI
APVD

TOWN OF SCOTIA, LLC
SCOTIA INFRASTRUCTURE IMPROVEMENTS-PHASE 3
SCOTIA, CALIFORNIA

STORM DRAIN

SHEET G-6
SEQ
DATE 09/2021
PROJ. NO. 005161.411

SAVED: 9/30/2021 1:59 PM CNEWELL, PLOTTED: 11/18/2021 3:32 PM NEWELL, CHRIS
\\Eureka\Projects\2005\005161-ScotiaMasterPlan\411-South-Town-Design\Dwgs\RECORD-DRAWINGS\Phase3\005161-411-STRM-MAINS-PHS3.dwg